

SECOND FLOOR & LOW ROOF FRAMING PLAN


- NOTES:
- VERIFY ALL DIMENSIONS & ELEVATIONS W/ ARCHITECTURAL DRAWINGS.
 - REFER TO ARCH'L DRAWINGS FOR TOP OF SHEATHING ELEVATIONS.
 - PLYWOOD WEB JOIST (PWJ) INDICATED ON PLAN SHALL BE REDBUILT TYP 1-65 (ICC ESR #2994), UON.
 - PROVIDE 2 ROWS BN AT ALL MEMBERS DESIGNATED AS "STRUT".

- LEGEND:
- WOOD POST
 - SPAN INDICATOR
 - BEAM SIZE
 - INDICATES MECHANICAL UNIT LOCATION. SEE PLAN FOR MAX HEIGHT SUPPORT FRAMING AND ANCHORAGE. PER
 - (N) PLYWOOD SHEATHING AREA

REVISIONS	
DATE/DELTA	REMARKS
10/29/19	PLAN CHECK
5/06/21	COORDINATION
11/29/21	PLAN REVISION

CHILDREN'S MINISTRY
LANCASTER BAPTIST CHURCH
4020 LANCASTER BLVD.
LANCASTER, CALIFORNIA

BICKEL GROUP
ARCHITECTURE
BICKEL GROUP INCORPORATED
3600 BIRCH STREET, SUITE 120
NEWPORT BEACH, CA 92660
P: 949.757.0411 F: 949.757.0511
www.bickelgrp.com

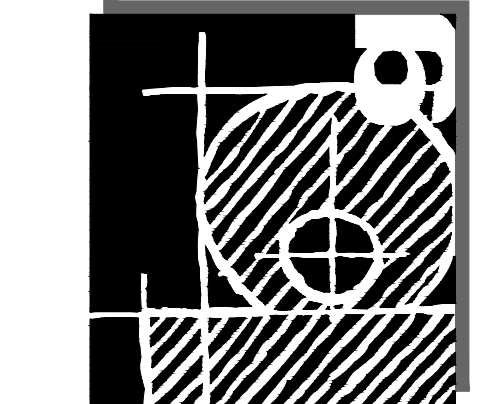

SHEET TITLE:
SECOND FLOOR & LOW ROOF FRAMING PLAN

SUB DATE
BID DATE

DATE: 05/08/19
DRAWN BY: AC
JOB NO: 181257
CHECKED BY: CMH

SHEET NUMBER:
S2.2