

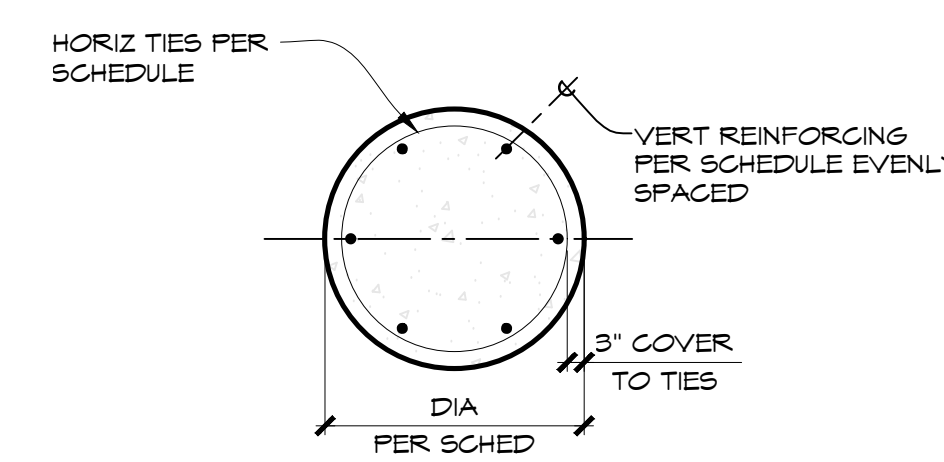
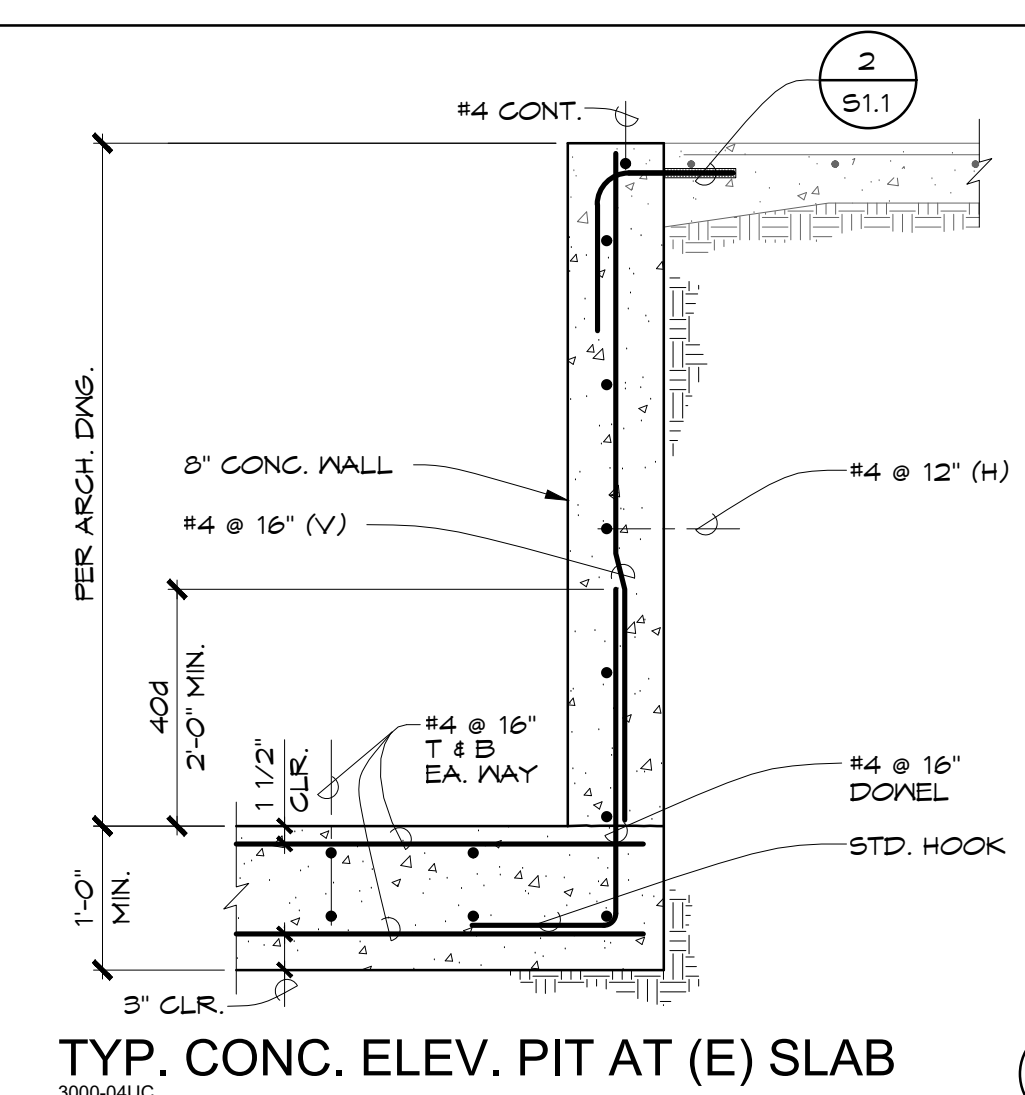


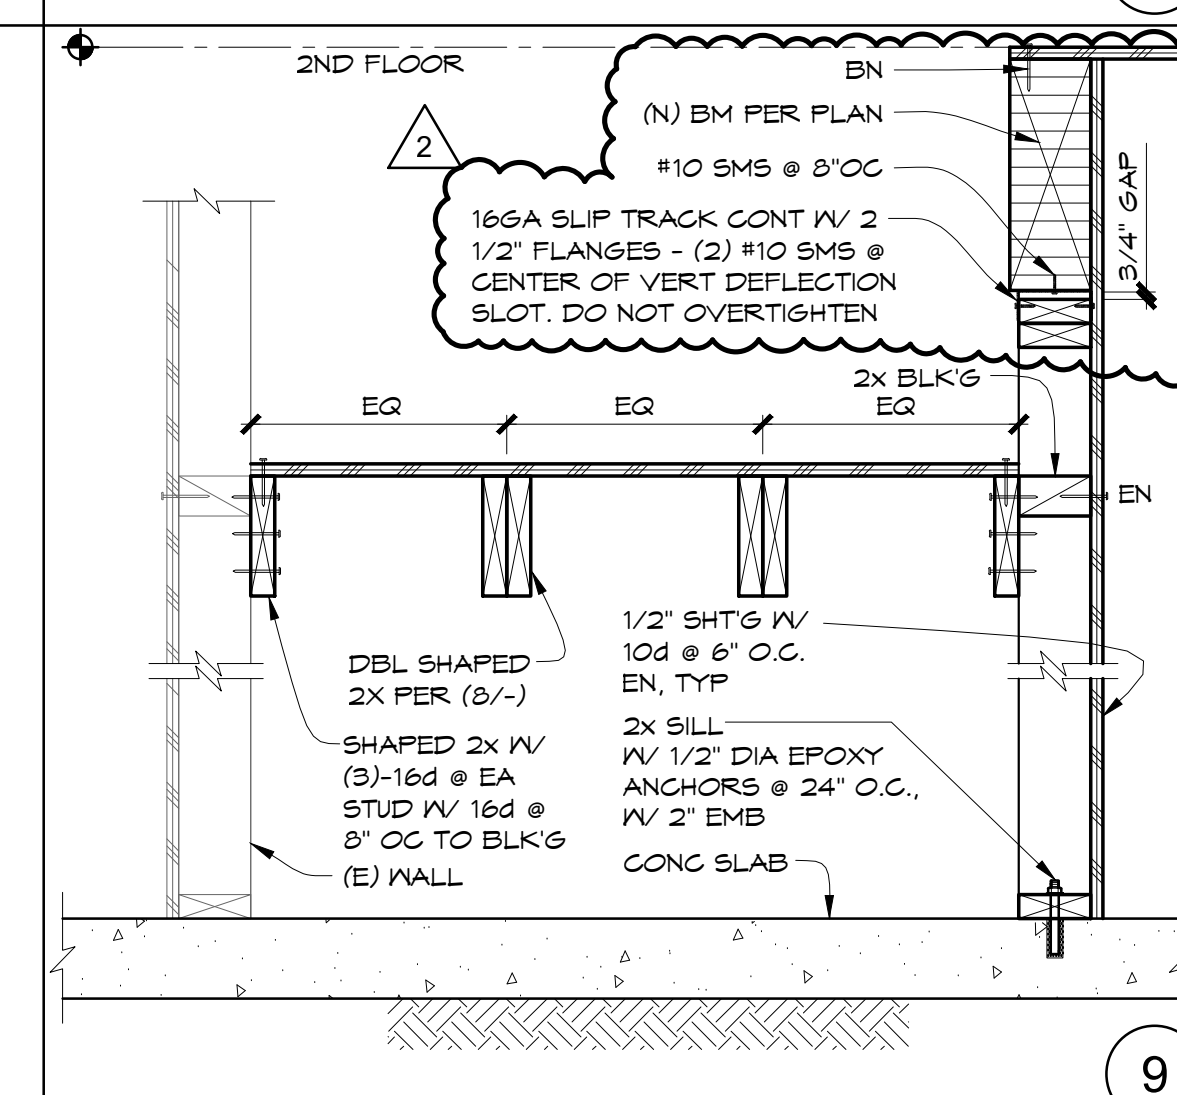


PILE CAP SCHEDULE							
MARK	PILE MIN		CAP				DETAIL
	DIA	DEPTH	VERT REINF	DIM	THICKNESS	REINF	
PC1A	2'-0"	35'-0"	(#) 6#	4'-0"x4'-0"	2'-0"	(#) 5# EA WAY T&B	--
PC1B	1'-6"	20'-0"	(#) 6#	4'-0"x4'-0"	2'-0"	(#) 5# EA WAY T&B	--
PC2A	1'-6"	30'-0"	(#) 6#	PER PLAN	PER PLAN	PER PLAN	2/-
PC2B	1'-6"	20'-0"	(#) 6#	PER PLAN	PER PLAN	PER PLAN	2/-

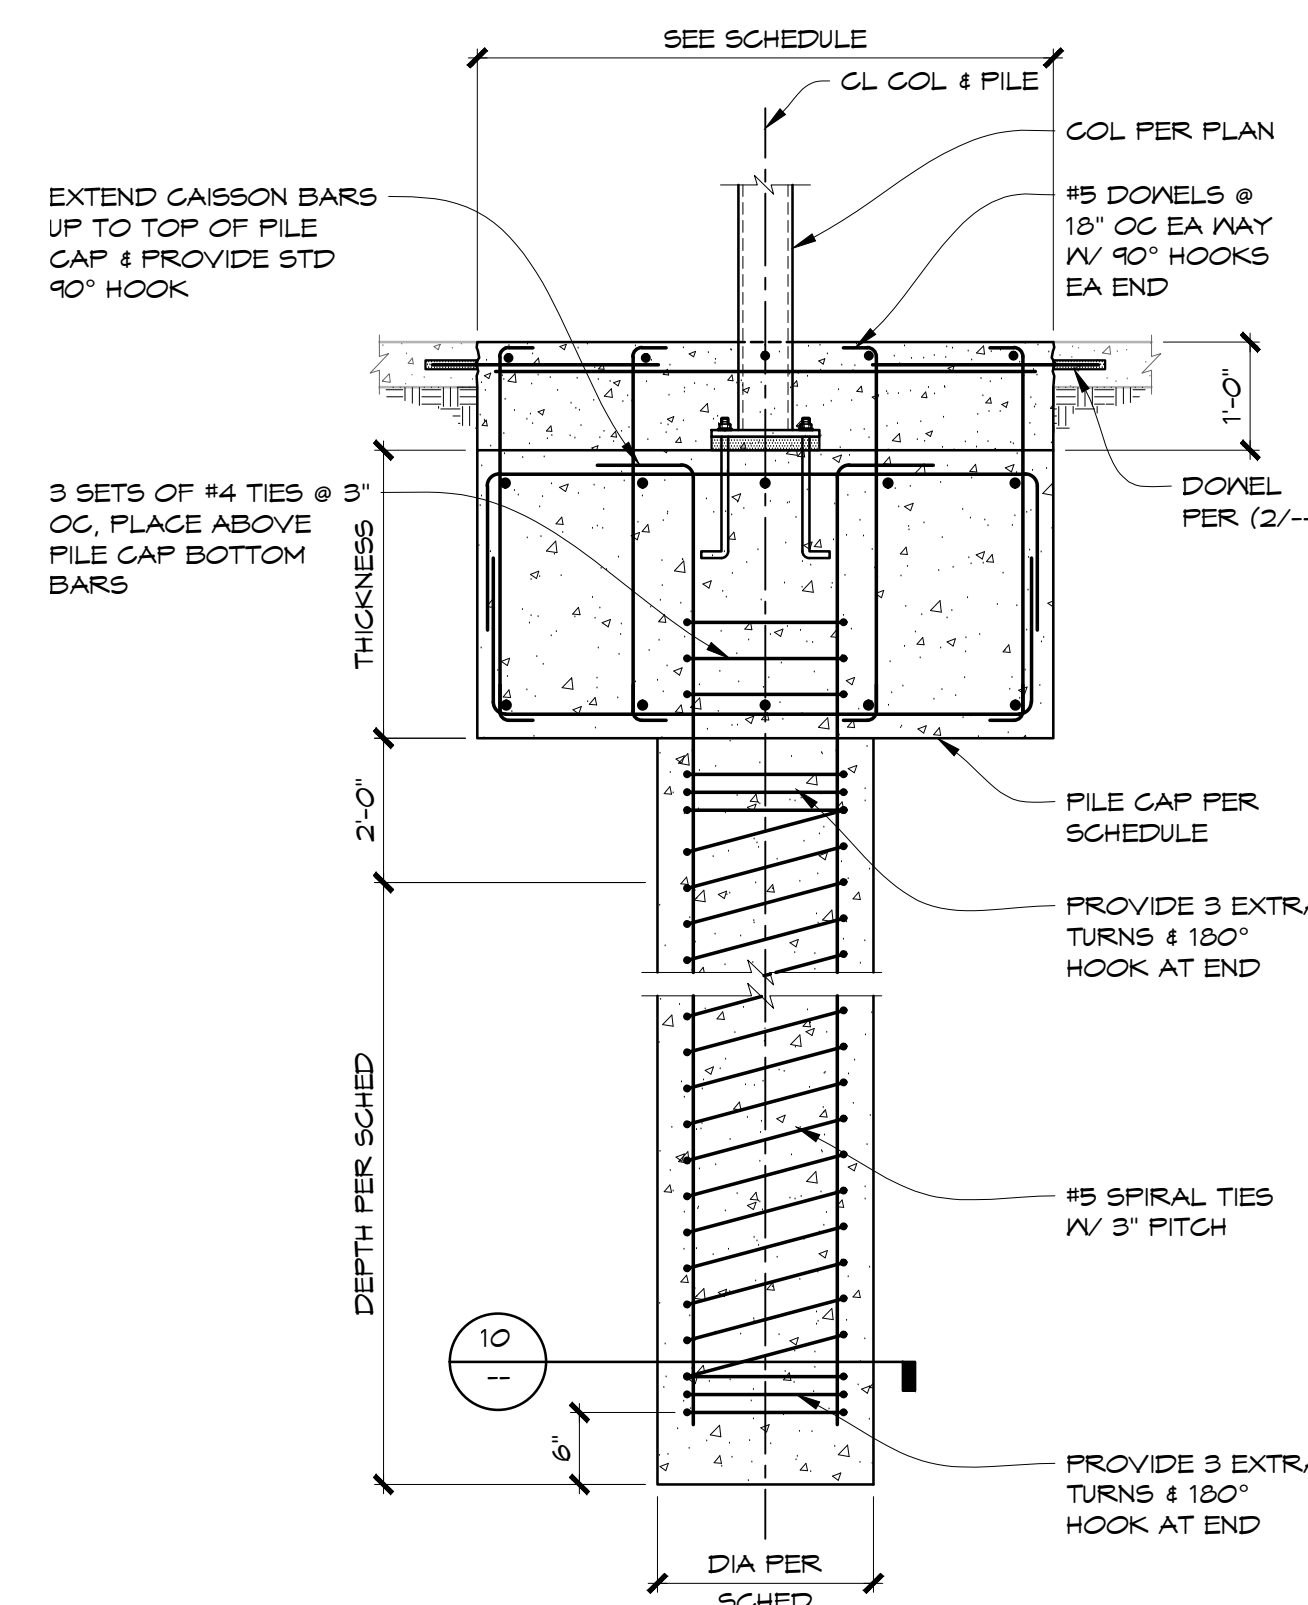


REVISIONS		
	DATE/DELTA	REMARKS
	10/29/19	PLAN CHECK
	5/06/21	COORDINATION
	11/29/21	PLAN REVISION

CHILDREN'S MINISTRY
LANCASTER BAPTIST CHURCH
4020 LANCASTER BLVD.
LANCASTER, CALIFORNIA

BICKEL GROUP
ARCHITECTURE
BICKEL GROUP INCORPORATED
3600 BIRCH STREET, SUITE 120
NEWPORT BEACH, CA 92660
P: 949.757.0411 F: 949.757.0511
www.bickelgroup.com



COFFMAN
ENGINEERS

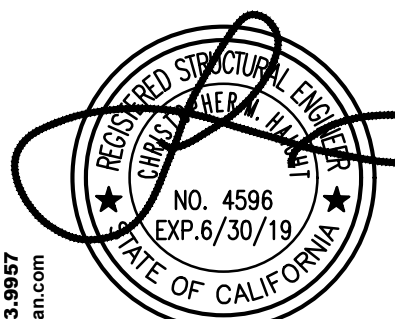

The plans, ideas, arrangements and designs indicated or represented by this drawing are owned by, and are the property of BICKEL GROUP, and were created and developed solely for use on, and in connection with this specific project, and shall not be used, in whole or in part, for any purpose for which they were not originally intended without written permission from BICKEL GROUP © 2018

SHEET TITLE:

STRUCTURAL DETAILS

SUB DATE

BID DATE	01/25/2017
-----------------	------------

DATE: 05/08/19

DRAWN BY: AC
JOB NO: 181257

SHEET NUMBER

S4.1